


(A) = 80ft
 (B) = 78ft
 (C) = 80ft
 (D) = 78ft
 ABCD = 6240
 (E) = 90ft
 (F) = 90ft
 (G) = 40ft
 EFG = 5760
 Total = 12000



1 patron / 7 sq ft
 = 1715 patrons
 Proposed Occupancy - 900

ORIGINAL DRAWING DATE March 26, 2023	EVENT DATE July 18/24	SHOW/EVENT PBR - Beer Garden	DRAWING # 1.0
REVISION DATE June 28, 2023	VENUE Prospera Place	DRAWING TITLE OVERVIEW - ORTHO	
DRAWN BY QUINN ALLEN quinn.allen@gslnetwork.ca		NOTES GREEN LINE IS EXISTING LIQUOR LICENCE RED LINE IS THE EXTENSION FOR BEER GARDEN	

Temporary Extension of License Area
LCRB Job #078821
Liquor Primary Licence # 189541
Capacity of the extended area = 900
Date: July 20, 2023

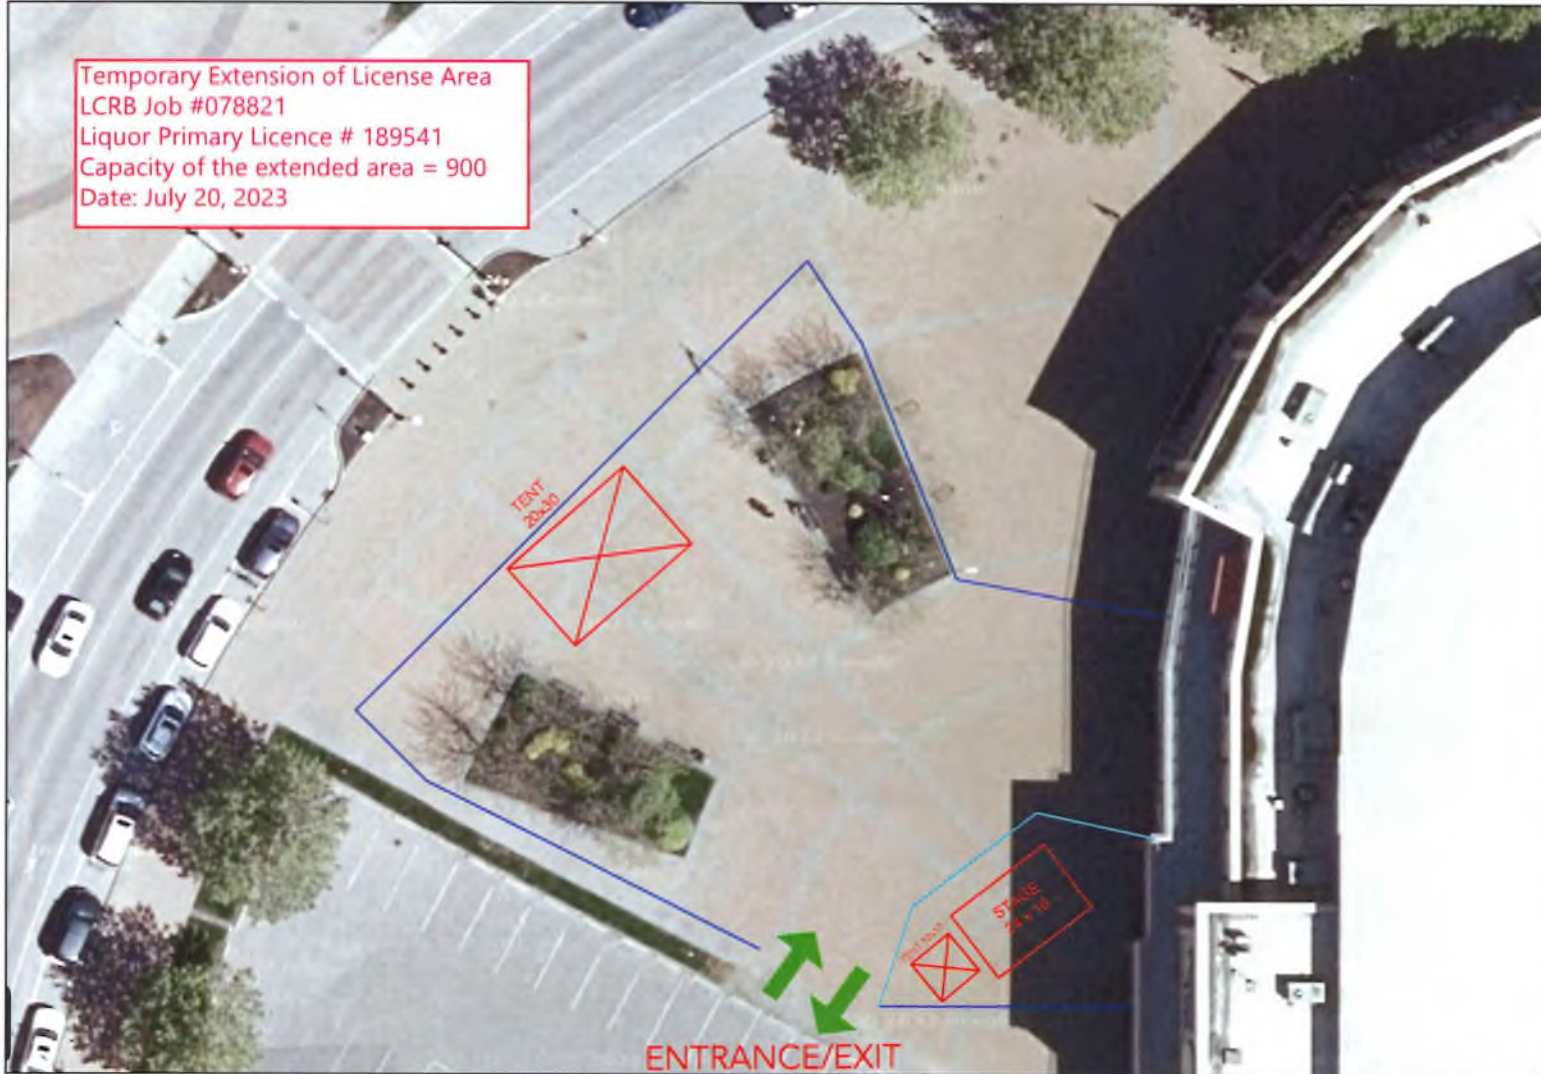

General Notes

- Add the size on it and date
- Sign the initial date on the map


No.	1	1/1	June 20, 2023
-----	---	-----	---------------

Project Name - 1234 Street St, Toronto, ON M1M 1P1

Site - New Addition and Change
Drawn by: S. Kim

Project	Sheet
1234 Street St	1.0
Date	
June 20, 2023	
Scale	
1:1	

USER REV/DATE FNAME

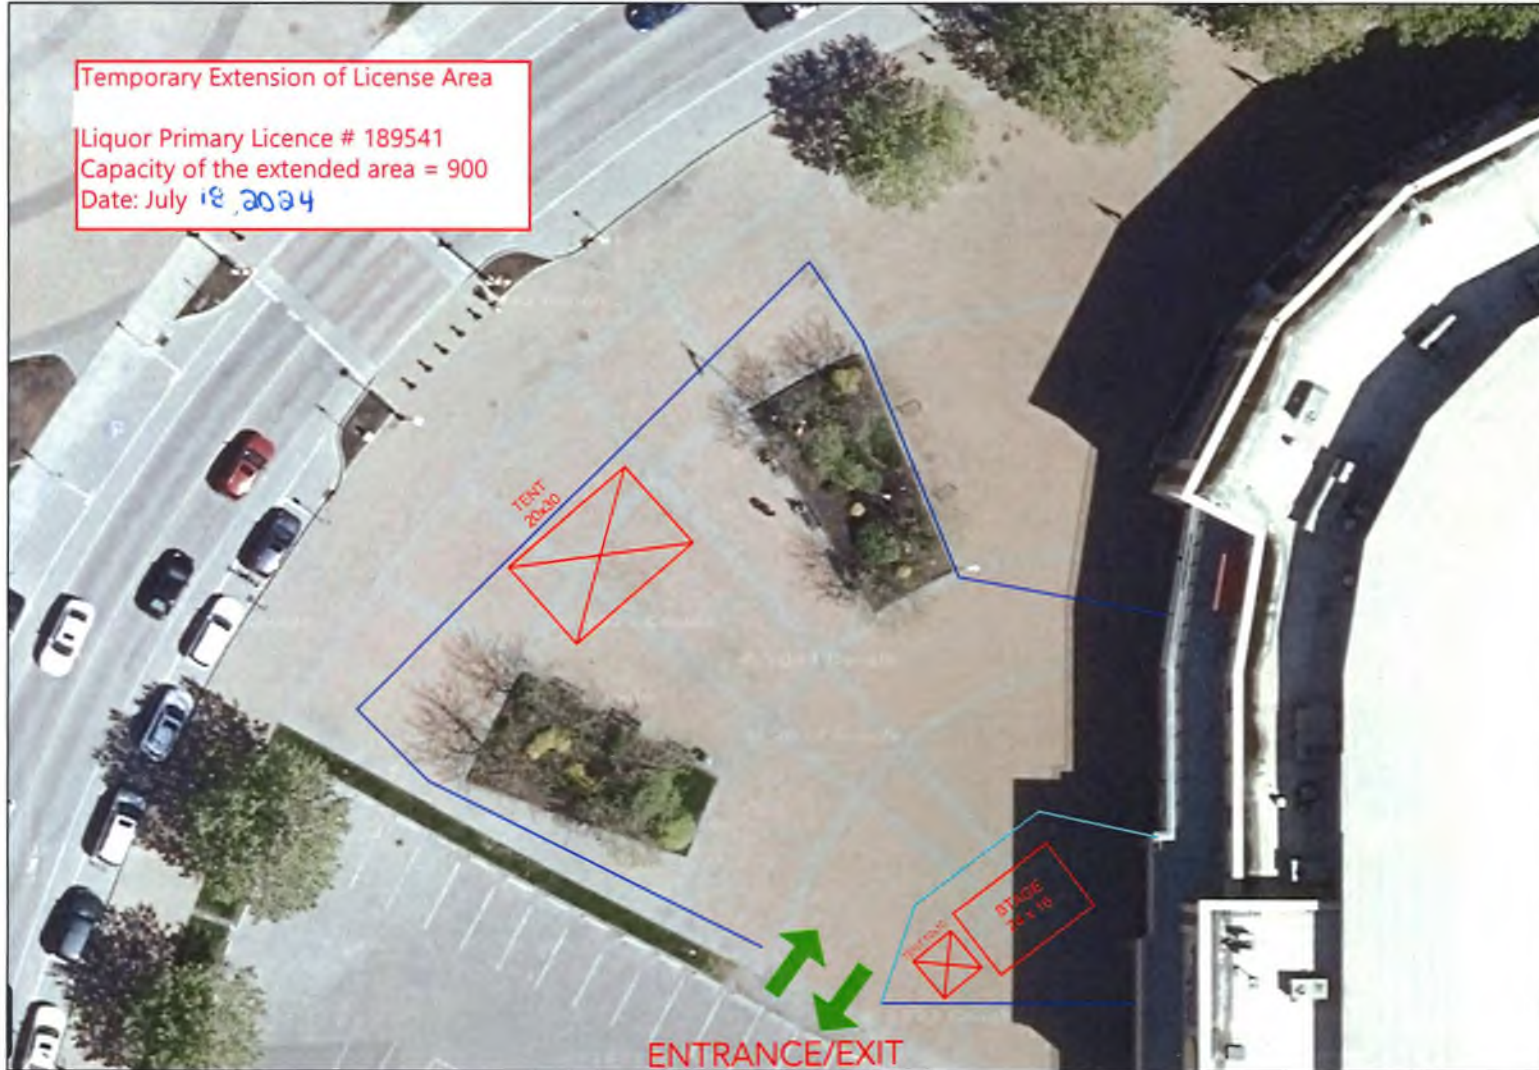

General Notes

- Red line box on it had been
- Light blue shaded box on the map

No. 1	1/1	June 5, 2023
-------	-----	--------------

Project Name - 100 West St, Stearns, WI 53187

File Name - 100 West St Stearns, WI 53187

Scale 1.0

(A) = 80ft
 (B) = 78ft
 (C) = 80ft
 (D) = 78ft
 ABCD = 6240
 (E) = 90ft
 (F) = 90ft
 (G) = 40ft
 EFG = 5760
 Total = 12000



Temporary Extension of License Area
 LCRB Job #078821
 Liquor Primary Licence # 189541
 Capacity of the extended area = 900
 Date: July 20, 2023

1 patron / 7 sq ft
 = 1715 patrons
 Proposed Occupancy = 1000

ORIGINAL DRAWING DATE March 26, 2023	EVENT DATE July 20, 2023	SHOW/EVENT PBR - Beer Garden	DRAWING # 1.0
REVISION DATE June 28, 2023	VENUE Prospera Place	DRAWING TITLE OVERVIEW - ORTHO	
DRAWN BY QUINN ALLEN quinn.allen@gslnetwork.ca	NOTES GREEN LINE IS EXISTING LIQUOR LICENCE RED LINE IS THE EXTENSION FOR BEER GARDEN		